


Map # 9  
Town of Campton  
New Town  
Office

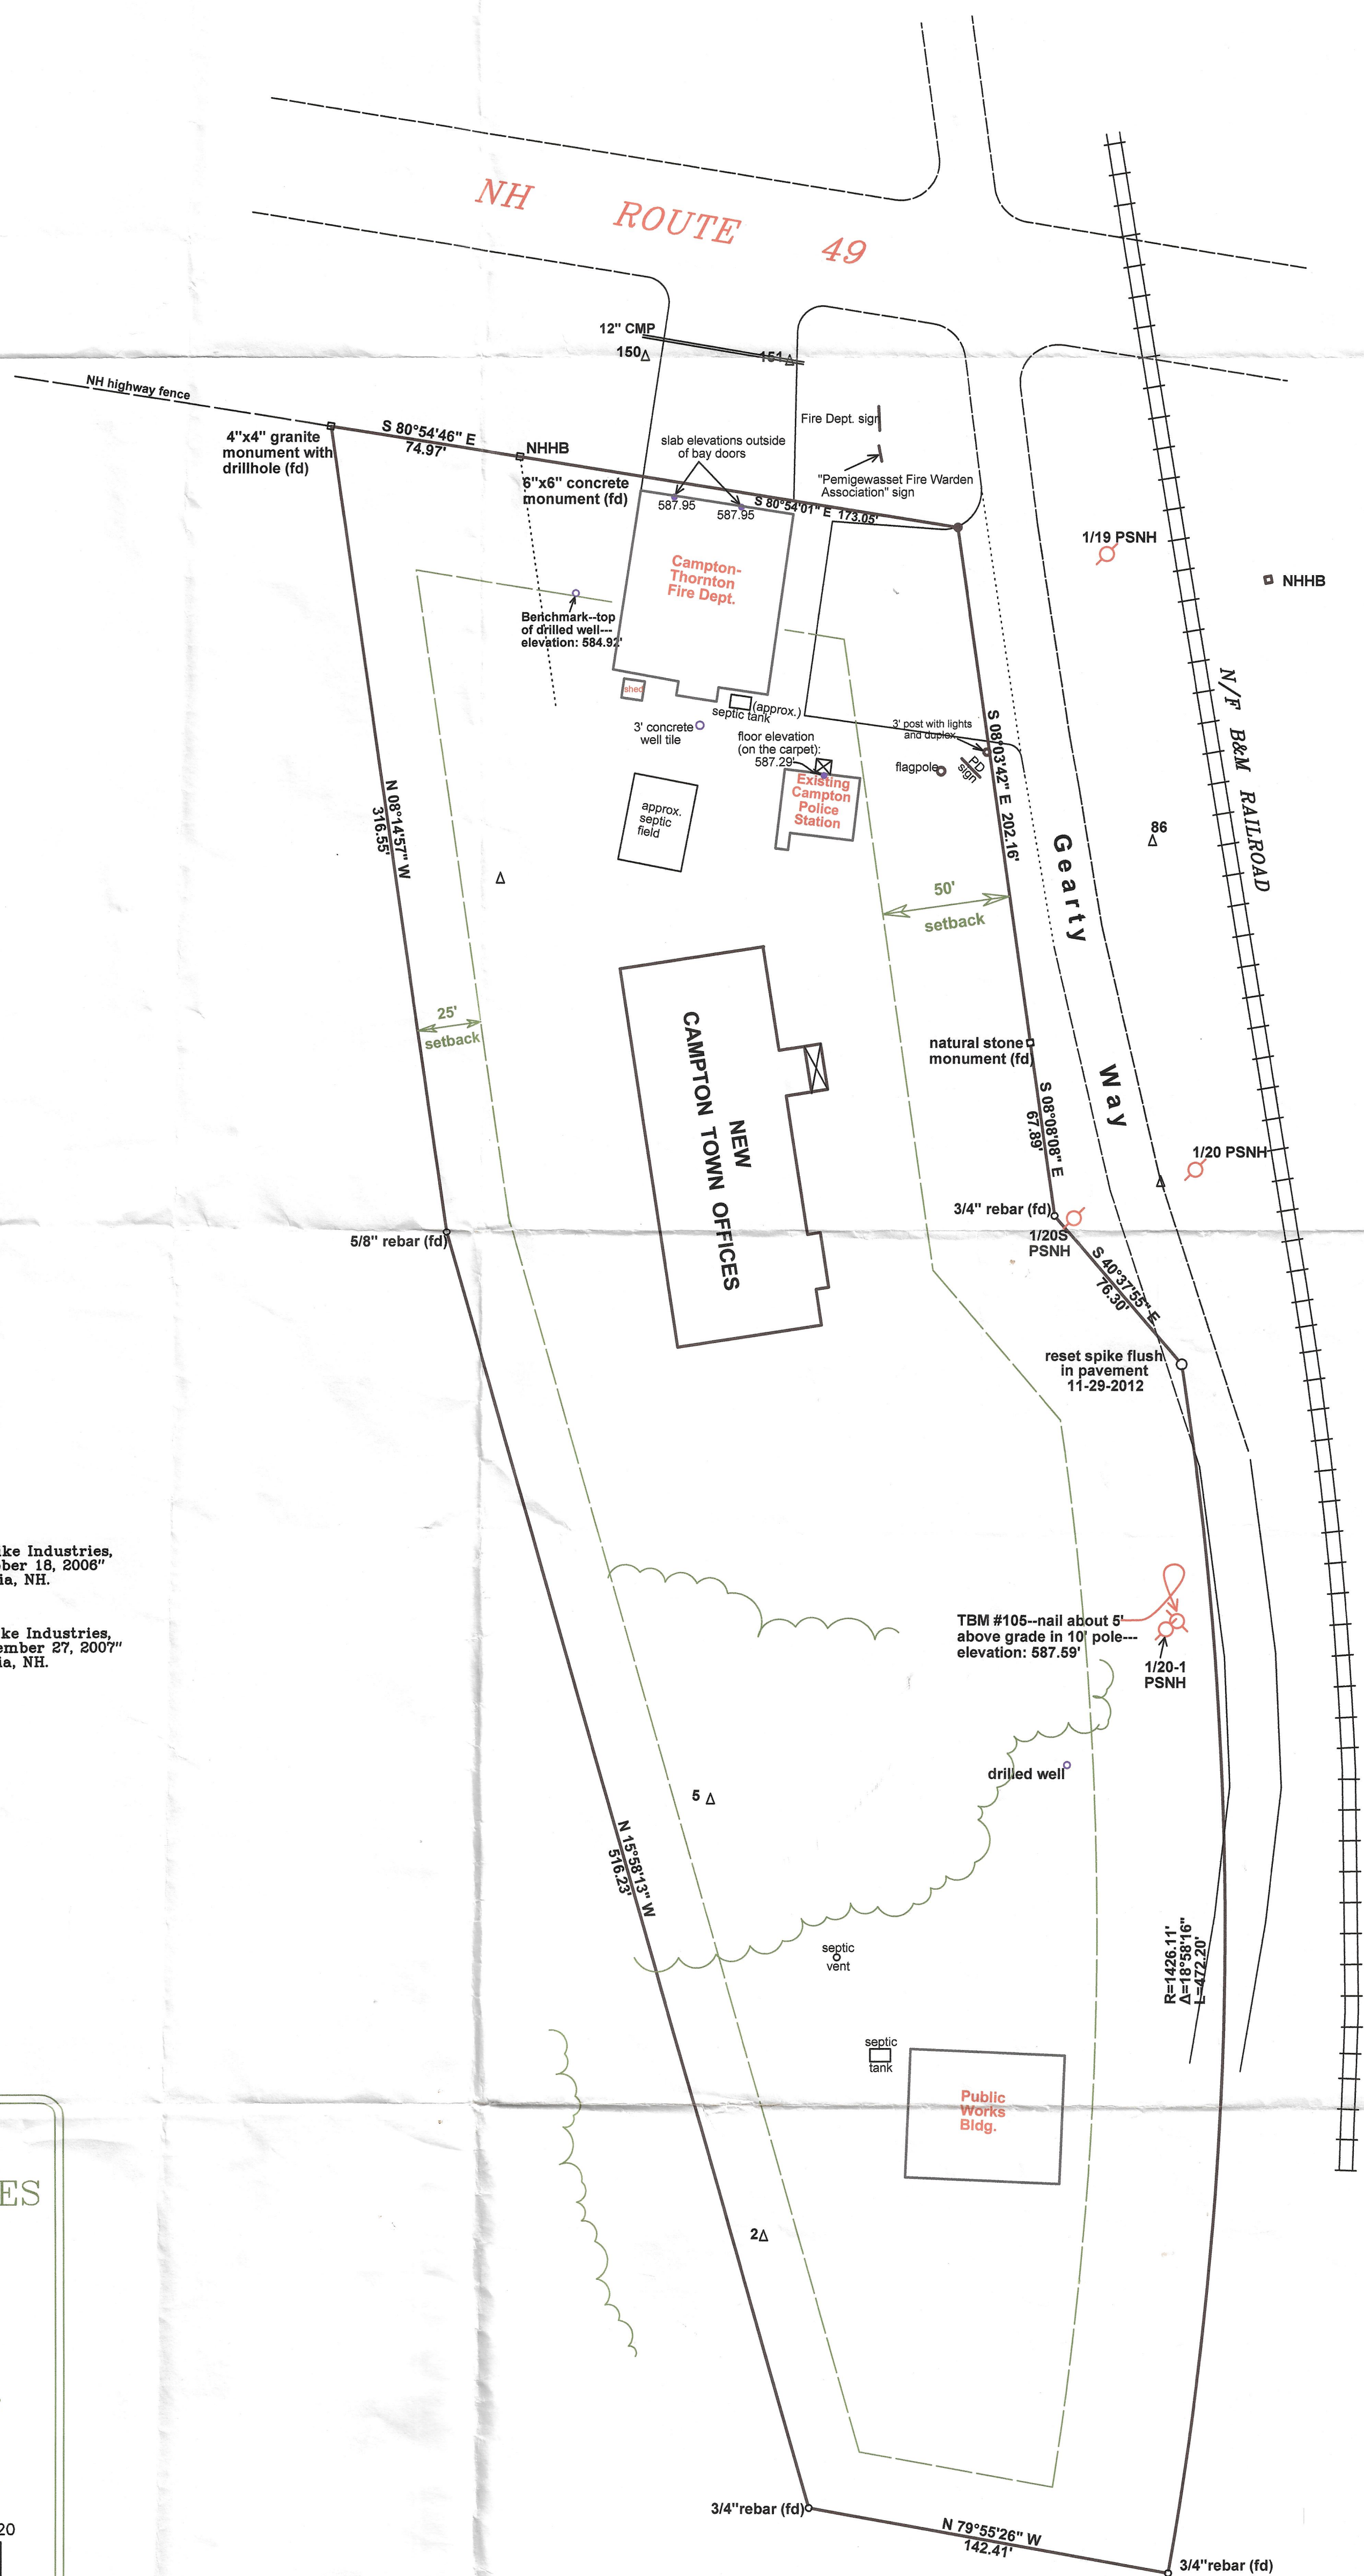

**Reference Plans**

1. "Boundary Line Adjustment Survey Plan of Land of Pike Industries, Inc. & Town of Campton, Route 49, Campton, NH, October 18, 2008" Scale: 1"=50' by Yerkes Surveying Consultants, Laconia, NH.
2. "Boundary Line Adjustment Survey Plan of Land of Pike Industries, Inc. & Town of Campton, Route 49, Campton, NH, November 27, 2007" Scale: 1"=50' by Yerkes Surveying Consultants, Laconia, NH.

LEGEND	
	stone wall
	iron pipe or pin
	wire fence
	concrete monument
	drainage
	utility pole
	poorly drained soils
	calculated pt.

SITE PLAN  
for  
**CAMPTON TOWN OFFICES**  
Gearty Way  
Campton, N.H.

Tax Map Parcel 9-13-1  
Total area 4.20 acres

Deeds: 1238/544, 1296/800, 1574/216

Zones: Commercial Zone and  
River Corridor Protection Zone

Scale 1" = 40'

Survey & Plan : MOUNTAIN MAPPING  
Campton, N. H.  
Date : May 2008  
As-Built Plan : November 2012

